

COPY RIGHT NOTES:
 1. THIS DRAWING AND ITS CONTENT IS COPY RIGHT PROTECTED AS AN ARTISTIC WORK (Section 2c), IN TERMS OF THE SA COPY RIGHT ACT No 98 OF 1978, IN ITS ENTIRETY.
 2. THIS DRAWING, ITS CONTENTS AND THE ACTUAL BUILDING IT PORTRAYS, MAY NOT BE ADAPTED, COPIED, DISTRIBUTED, DISTORTED, MODIFIED OR REPRODUCED IN ANY WAY OR FORM BY ANY PARTY, WHICH INCLUDES, BUT IS NOT LIMITED TO CLIENTS, CONSULTANTS OR ANY OTHER OR 3rd PARTIES, WITHOUT THE EXPRESS WRITTEN APPROVAL OF THE AUTHOR(S), BEING MBH ARCHITECTS Pty Ltd OR ANY OF ITS PRINCIPALS (Section 3a&b).
 3. THE ISSUING OF THIS DRAWING BY THE AUTHOR(S), TO ANY PARTY, WHICH INCLUDES, BUT IS NOT LIMITED TO CLIENTS, CONSULTANTS OR ANY OTHER OR 3rd PARTY, SHALL IN NO WAY CONSTITUTE, OR BE CONSTRUED OR IMPLIED TO CONSTITUTE AN EXCLUSIVE LICENSE OR SUB-LICENSE, NOR THE TRANSFER, NOR THE ASSIGNMENT OF COPYRIGHT, TO EXIST BETWEEN THE AUTHOR(S) AND THE PARTY IT IS ISSUED TO, AND SHALL IN NO WAY BE INFERRED BY CONDUCT (Section 22(4)) UNLESS REDUCED TO WRITING (Section 22(3)).
 4. THIS DRAWING AND ITS CONTENT, SHALL BE USED EXCLUSIVELY FOR THE ERECTING OF THE BUILDING AS PORTRAYED, ON THE BUILDING SITE SO MENTIONED IN THE TITLE BLOCK (Section 15(2)).

ISO 9001 : 2015 COMPLIANT

No.	Description	Date

ISSUED FOR CONSTRUCTION
mbh International Sp. z o.o.

POLAND, EU


Architects, Interior & Industrial Designers
 +48 533 942 111 mbh.international.pl@gmail.com
 www.mbh-architects.com

LEVEL 1 B-BBEE Contributor

mbh Architects (Pty) Ltd

SOUTH AFRICA

Architects, Interior Designers & Industrial Designers
 +27 83 406 4988 - mbharchitectssa@gmail.com
 www.mbh-architects.com

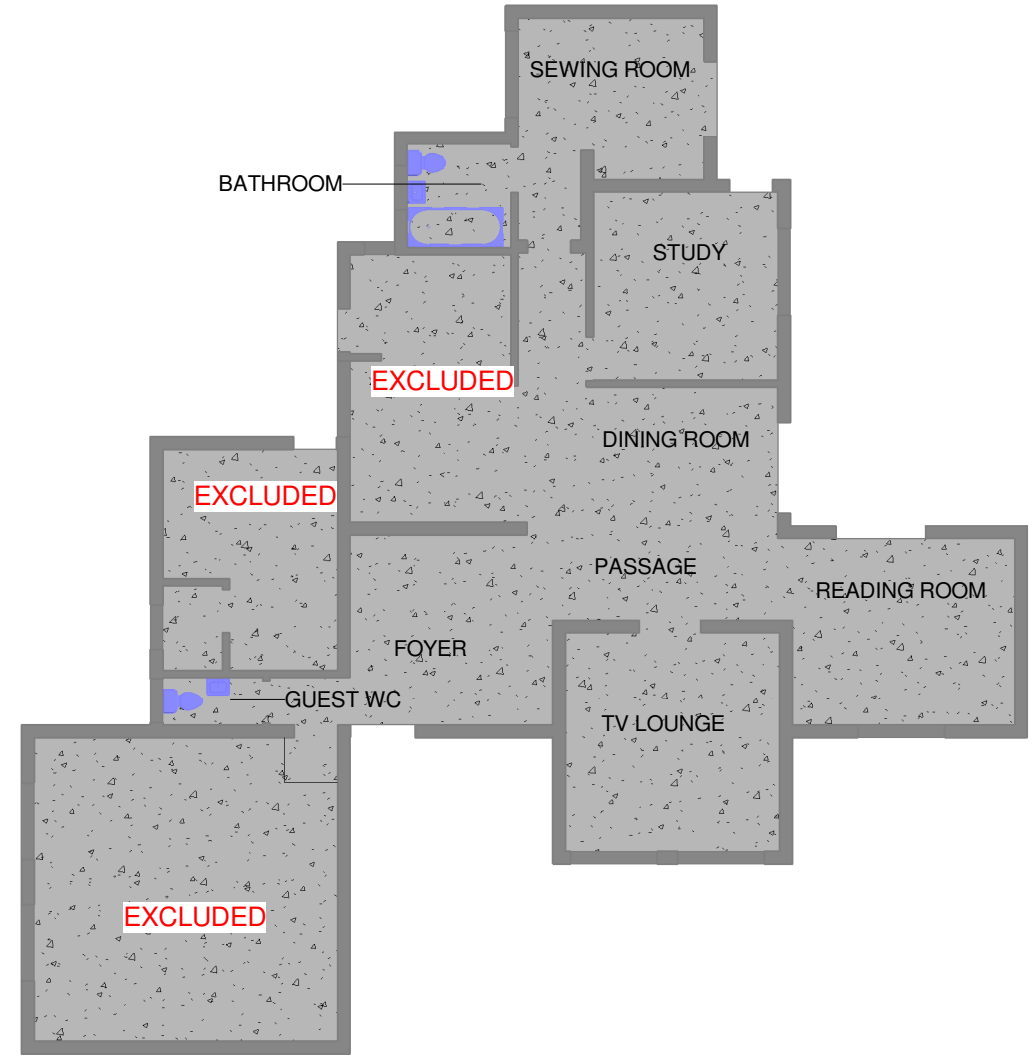

1 GROUND FLOOR - Demolition
 1 : 150

2 FIRST FLOOR - Demolition
 1 : 150

- DEMOLISH EXISTING - - - - -
- EXISTING TO REMAIN —————
- NEW BRICK WORK —————
- NEW DRY WALL —————
- NEW CONCRETE —————
- NEW STEEL —————
- NEW WALL & CORNER PROTECTION —————
- NEW BARIUM PLASTER - - - - -

NOTE : LOOSE FURNITURE & EQUIPMENT IS SHOWN FOR ILLUSTRATION PURPOSES ONLY. THIS DOES NOT FORM PART OF THE BUILDING PROJECT, UNLESS SPECIFIED.

CLIENT NAME
 Mr Franz Rossbacher

PROJECT NAME and ADDRESS
 House Rossbacher, 882
 Carlswald North Estate

DRAWING NAME
 AS BUILT & DEMOLITION
 PLANS

Drawing Issue Date 04 APRIL 2025

Project Architect MH

SACAP Reg No 20695

Drawn by BH

DRAWING NUMBER
 SHEET No-STOREY-BUILDING-UNIT-SECTION-DISCIPLINE-WORK STAGE REVISION No
 100-A

PROJECT No
 RES 25-04

Scale 1 : 150 Sheet Size **A3**

2025/04/24 09:04:33 AM